


NOTE:
 WINDOW AND DOOR LOCATIONS
 ARE NOT SCALED IN ON THIS DRAWING.

WILLARD
 LASALLE HOUSE
 2553 BUCKEYSTOWN PIKE
 GLENN REYNOLDS, ARCHITECT
 4.18.17

AS-BUILT

1ST FLOOR PLAN

Scale: 1/8" = 1'-0"

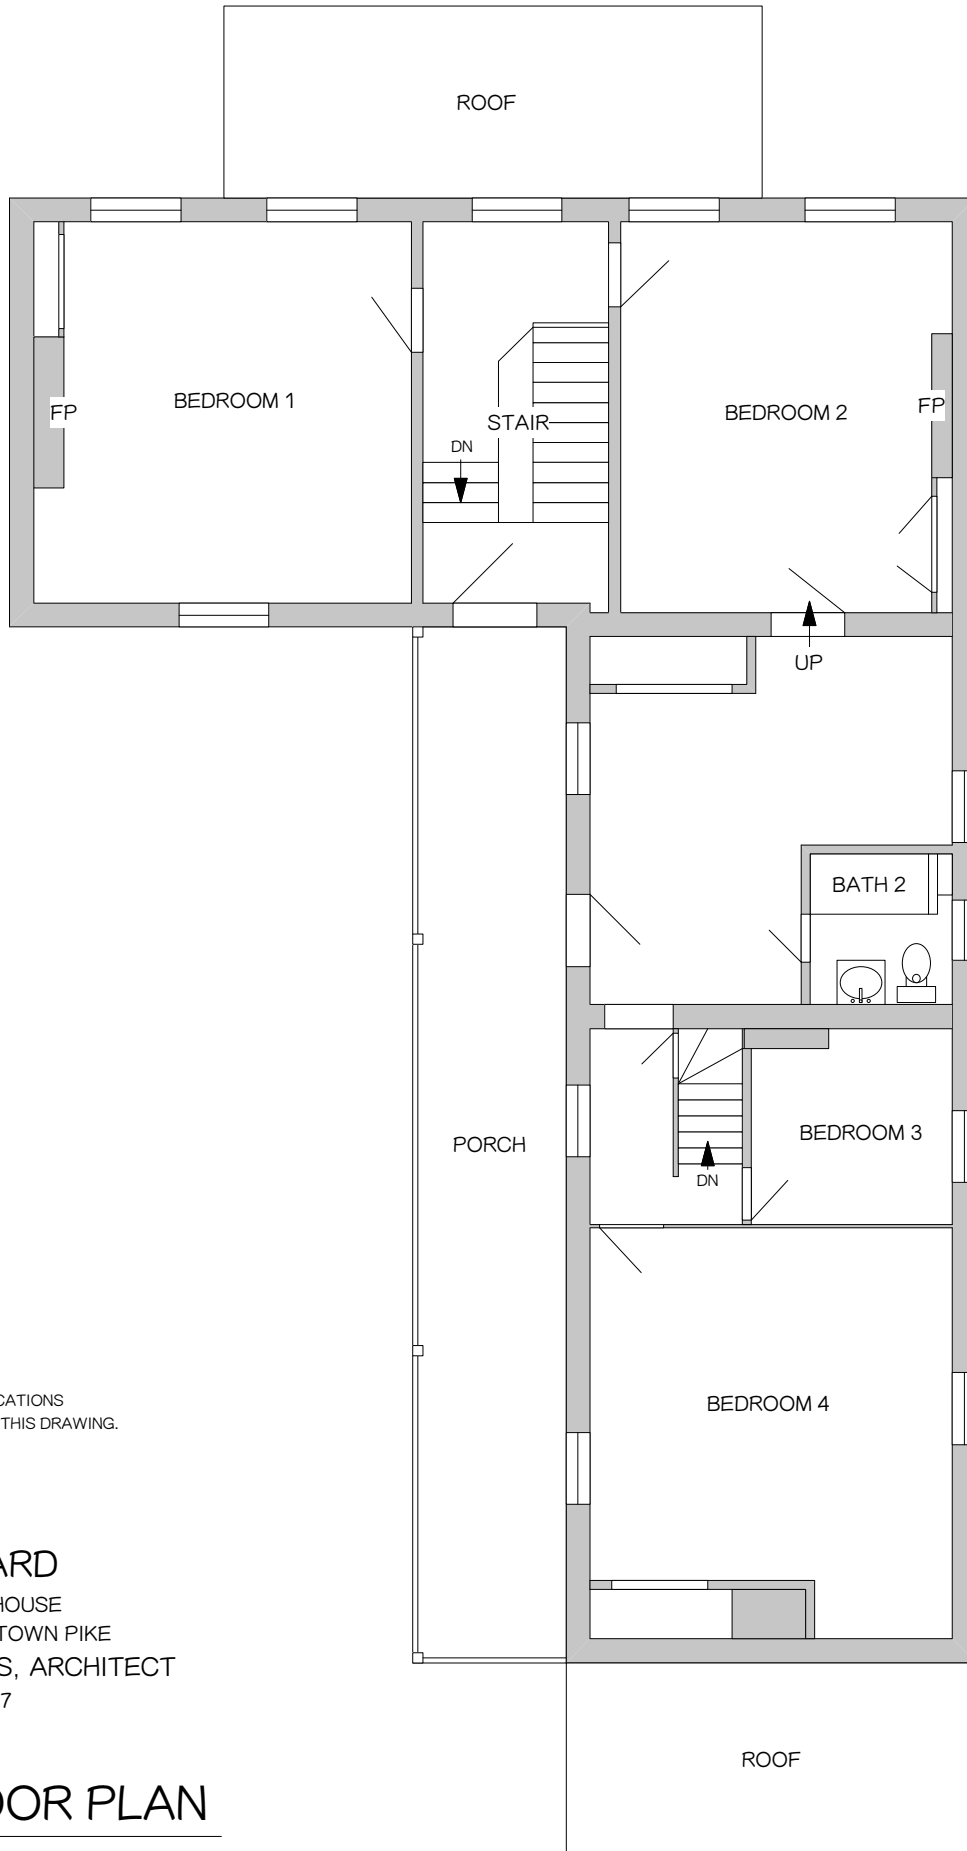

NOTE:
 WINDOW AND DOOR LOCATIONS
 ARE NOT SCALED IN ON THIS DRAWING.

WILLARD
 LASALLE HOUSE
 2553 BUCKEYSTOWN PIKE
 GLENN REYNOLDS, ARCHITECT
 4.18.17

AS-BUILT

2ND FLOOR PLAN

Scale: 1/8" = 1'-0"